

E

D

C

B

A

1

2

3

4

5



6

EE DD BB AA A B C D E F G-2 G H J K L M N P



29'-0" 32'-0" 30'-0" 30'-0" 32'-11" 32'-11" 32'-11" 32'-11" 31'-9" 32'-11" 32'-11" 32'-11" 32'-11" 30'-4" 12'-4"

14 13 12 11 10 9 8 7 6 5 4 3 2-1 2-1 2-1 3 2 2-1 3

2'-0" 30'-0"

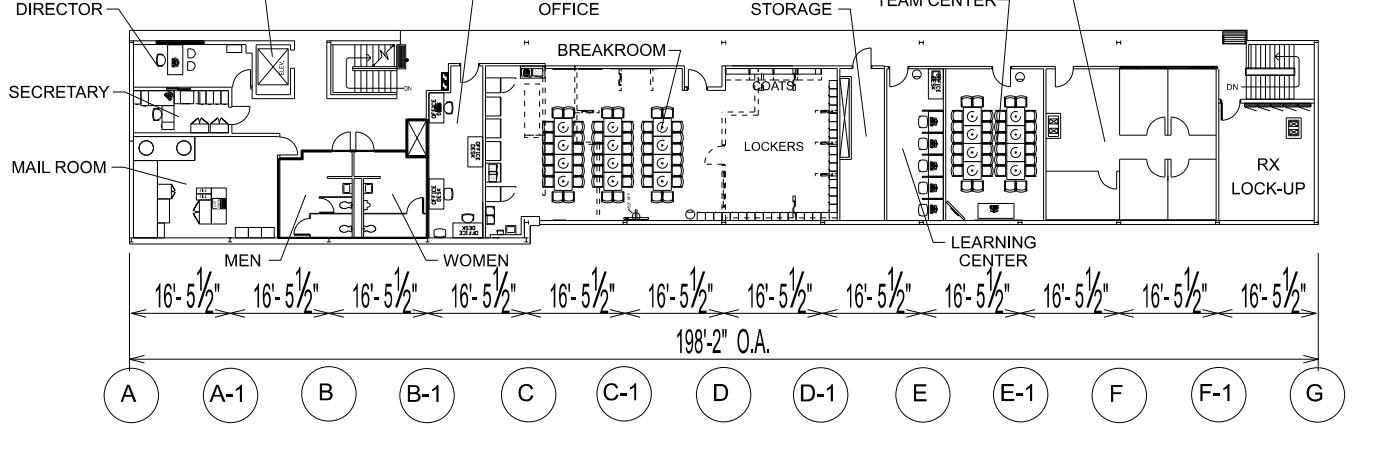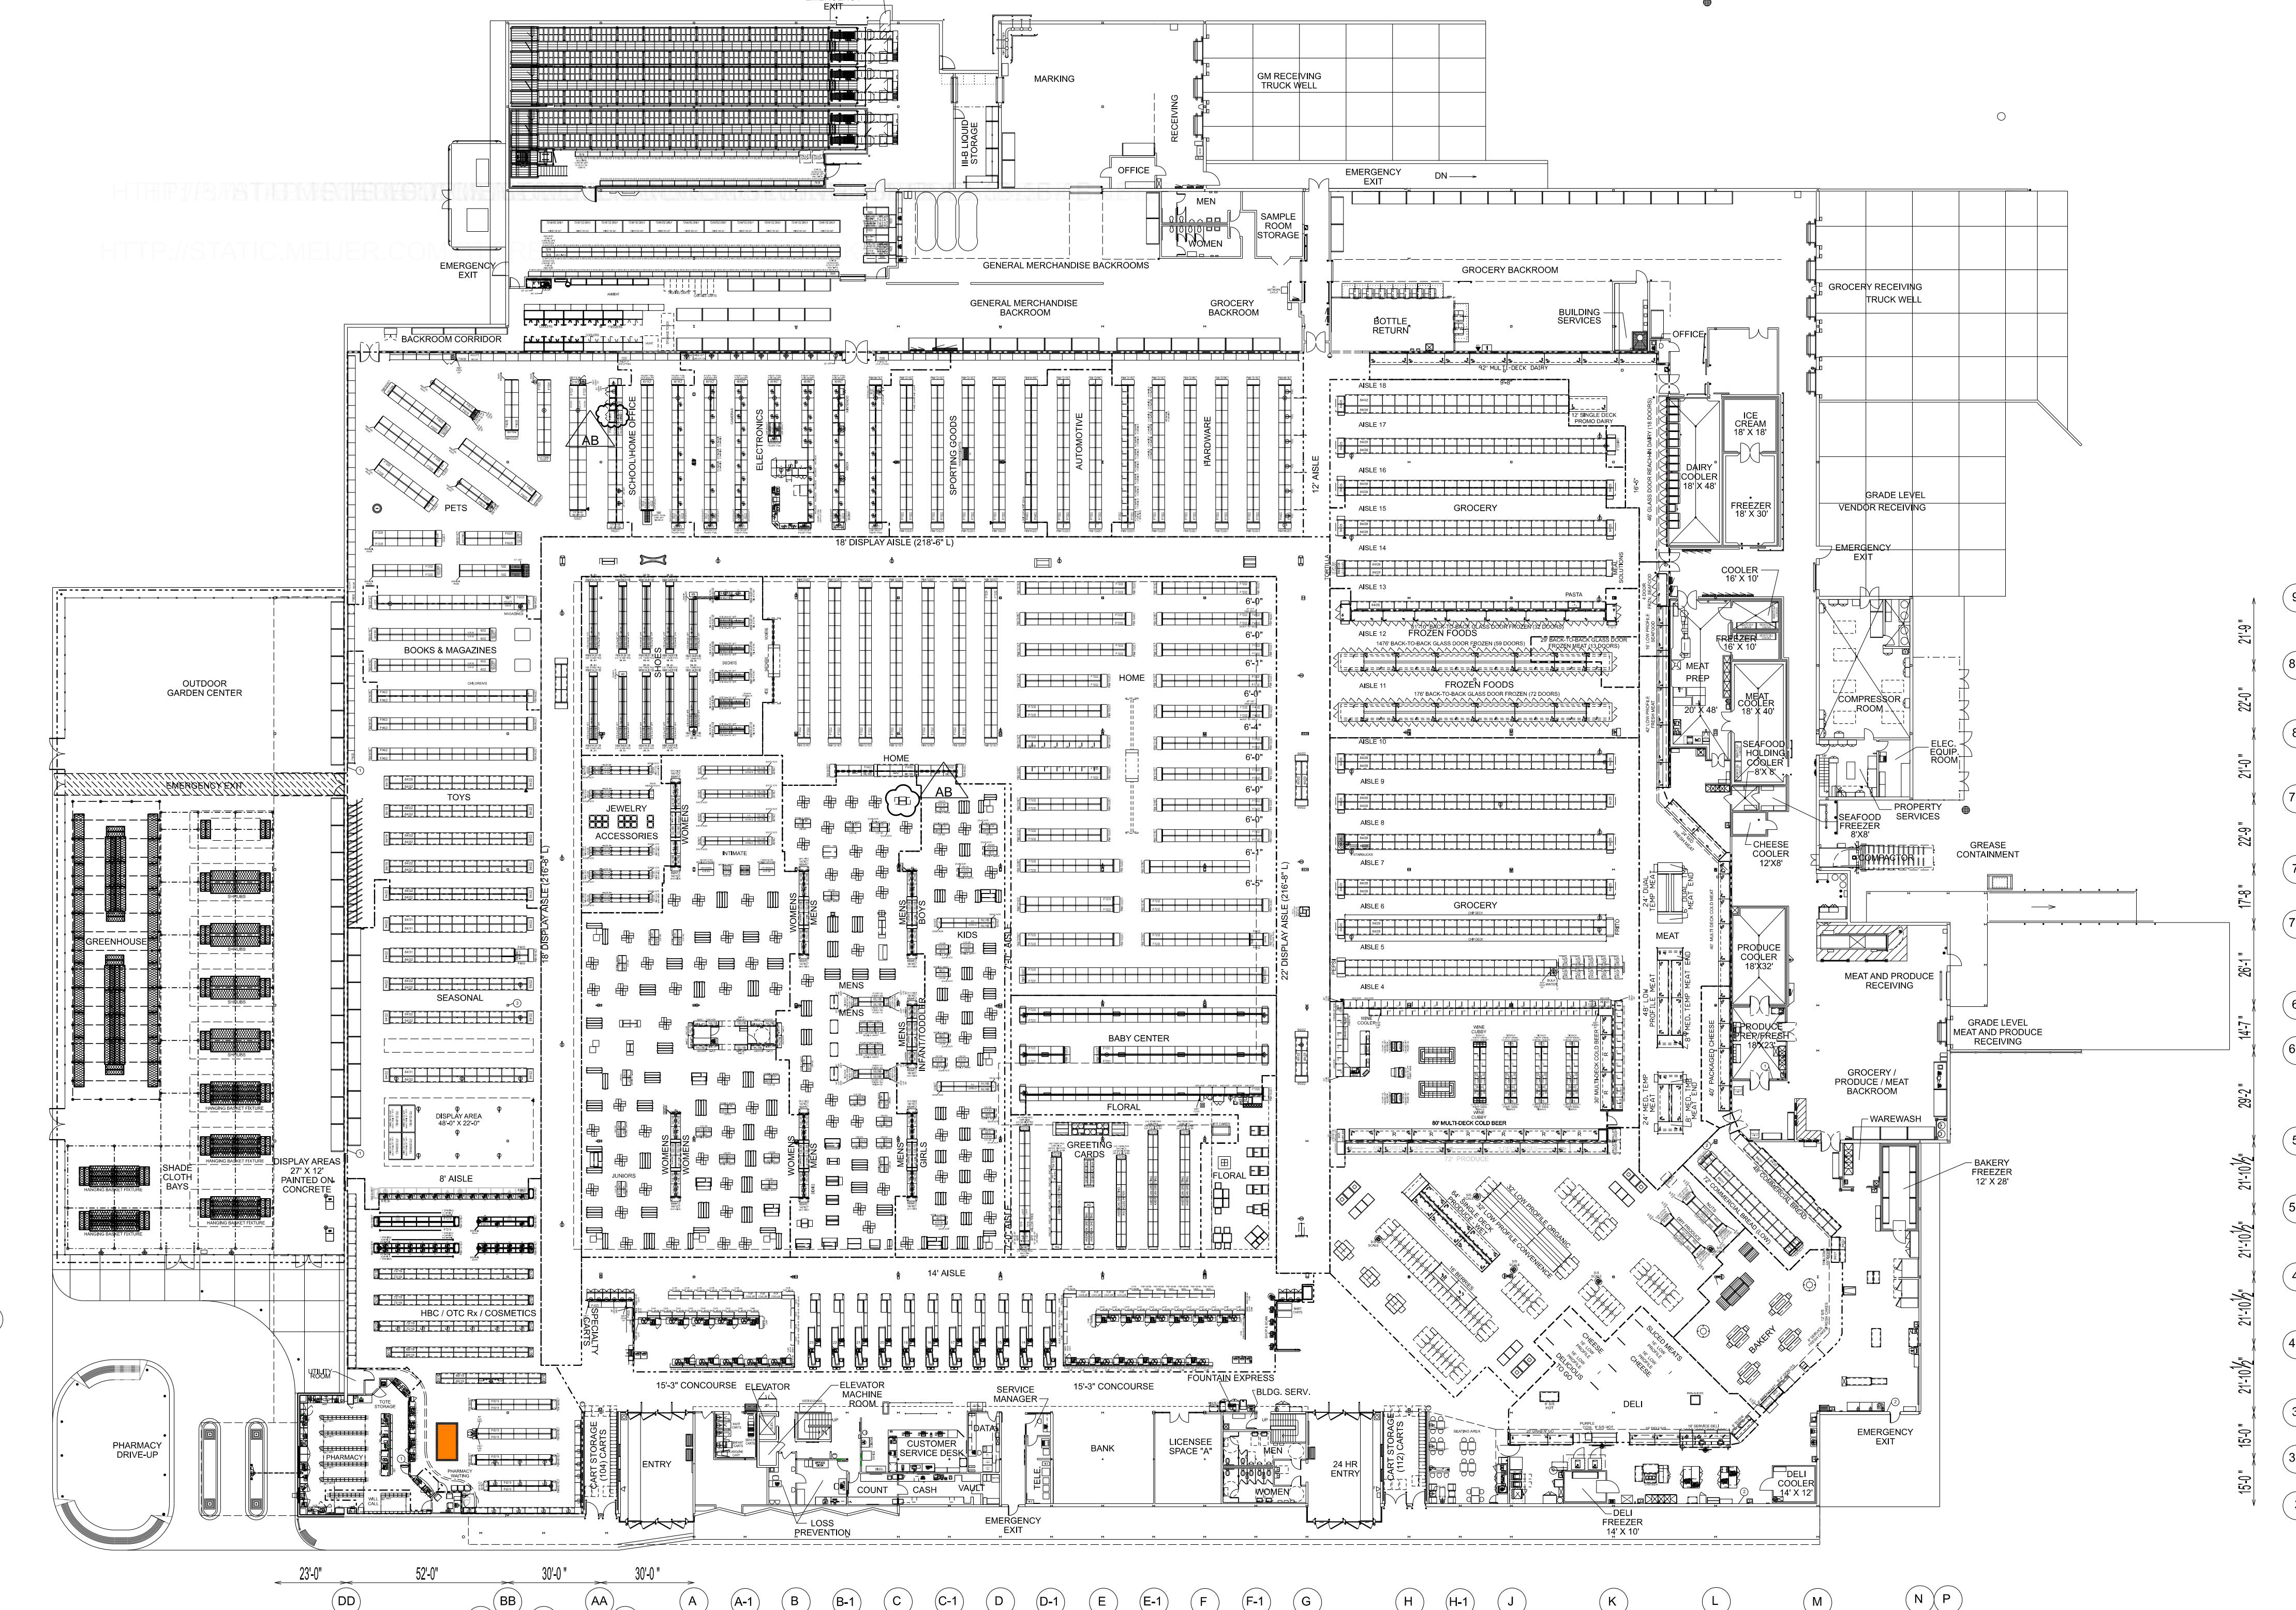

**FLOOR PLAN**  
SCALE: 1/32"=1'-0"

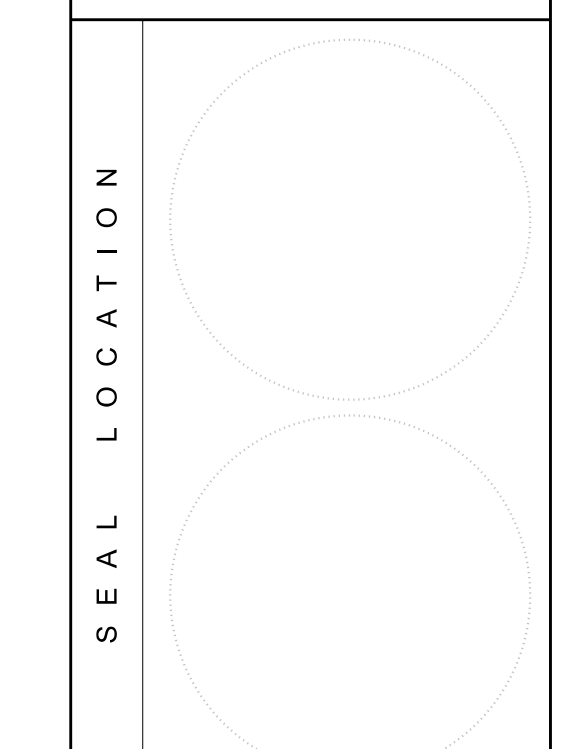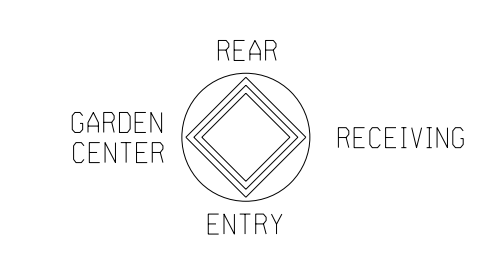

DATE	MARK	INITIALS	DESCRIPTION
01/01/2021	SW	/AB	REVISED & REISSUED PER AS-BUILT PRICE CHECKER
11/10/2021	SLO	/AB	REVISED & REISSUED PER AS-BUILT POPCORN
11/10/2021	ACB	/AB	REVISED & REISSUED PER AS-BUILT GROCERY RETAIL
11/10/2021	KOD	/AB	REVISED & REISSUED PER AS-BUILT MW
01/27/2022	ACB	/AB	REVISED & REISSUED PER AS-BUILT PRODUCE MOBILE REFRESH CASE
01/27/2022	CRS	/AB	REVISED & REISSUED PER AS-BUILT WOMEN'S COLUMBA
03/09/2022	ACB	/AB	REVISED & REISSUED PER AS-BUILT SHARED SERVICES
04/14/2022	ACB	/AB	REVISED & REISSUED PER AS-BUILT CENTER SERVICES
12/20/2022	KOD	/AB	REVISED & REISSUED PER AS-BUILT SPORTING GOODS INWIS CASE
12/20/2022	KOD	/AB	REVISED & REISSUED PER AS-BUILT PHOTO LAB CLOSURE
12/20/2022	KOD	/AB	REVISED & REISSUED PER AS-BUILT RTT TANKS RELOCATED
09/16/2023	SW	/AB	REVISED & REISSUED PER AS-BUILT HIGH BLOOD PRESSURE
09/16/2023	ACB	/AB	REVISED & REISSUED PER AS-BUILT DAIRY PACKAGED CHEESE
07/24/2024	DMA	/AB	REVISED & REISSUED PER AS-BUILT CHECKOUT MERCHANDISER
07/24/2024	AB	/AB	REVISED & REISSUED PER AS-BUILT HRUUP PROJECT
7/26/2024	NZ	/AB	REVISED & REISSUED PER AS-BUILT PET FREEZER
08/27/2024	AB	/AB	REVISED & REISSUED PER AS-BUILT NEWS BASIC PHASE 2
10/22/2024	JP	/AB	REVISED & REISSUED PER AS-BUILT COSTA DORF EMBLISON

**20 ALPINE AVE. - WALKER**  
2425 ALPINE AVENUE NW GRAND RAPIDS, MI  
SHEET TITLE:  
**2017 BRAND REFRESH FLOOR PLAN**

PROJECT NO: CP-17-01030  
ISSUE DATE: 04/14/2017  
DRAWN BY: M. MOY  
DESIGN BY: J. COFFEY  
CONTACT: R. FEDEWA  
© Copyright Meijer 2024

**Q100**

[LINK TO OTHER STORE FLOOR PLANS \(Meijer login required\)](#)

[LINK TO STORE 20 CORPORATE WEB SITE](#)

PRINTED 30 X 42, SCALE IS APPROXIMATELY 32:1  
IDDCS Cabinet: LAYOUT